

CONROE 500


500 Medical Center Blvd - Conroe, TX 77304

Floor Plan | Suite 360A | 6,552 SF
As-Built



TRANSWESTERN

REAL ESTATE
SERVICES

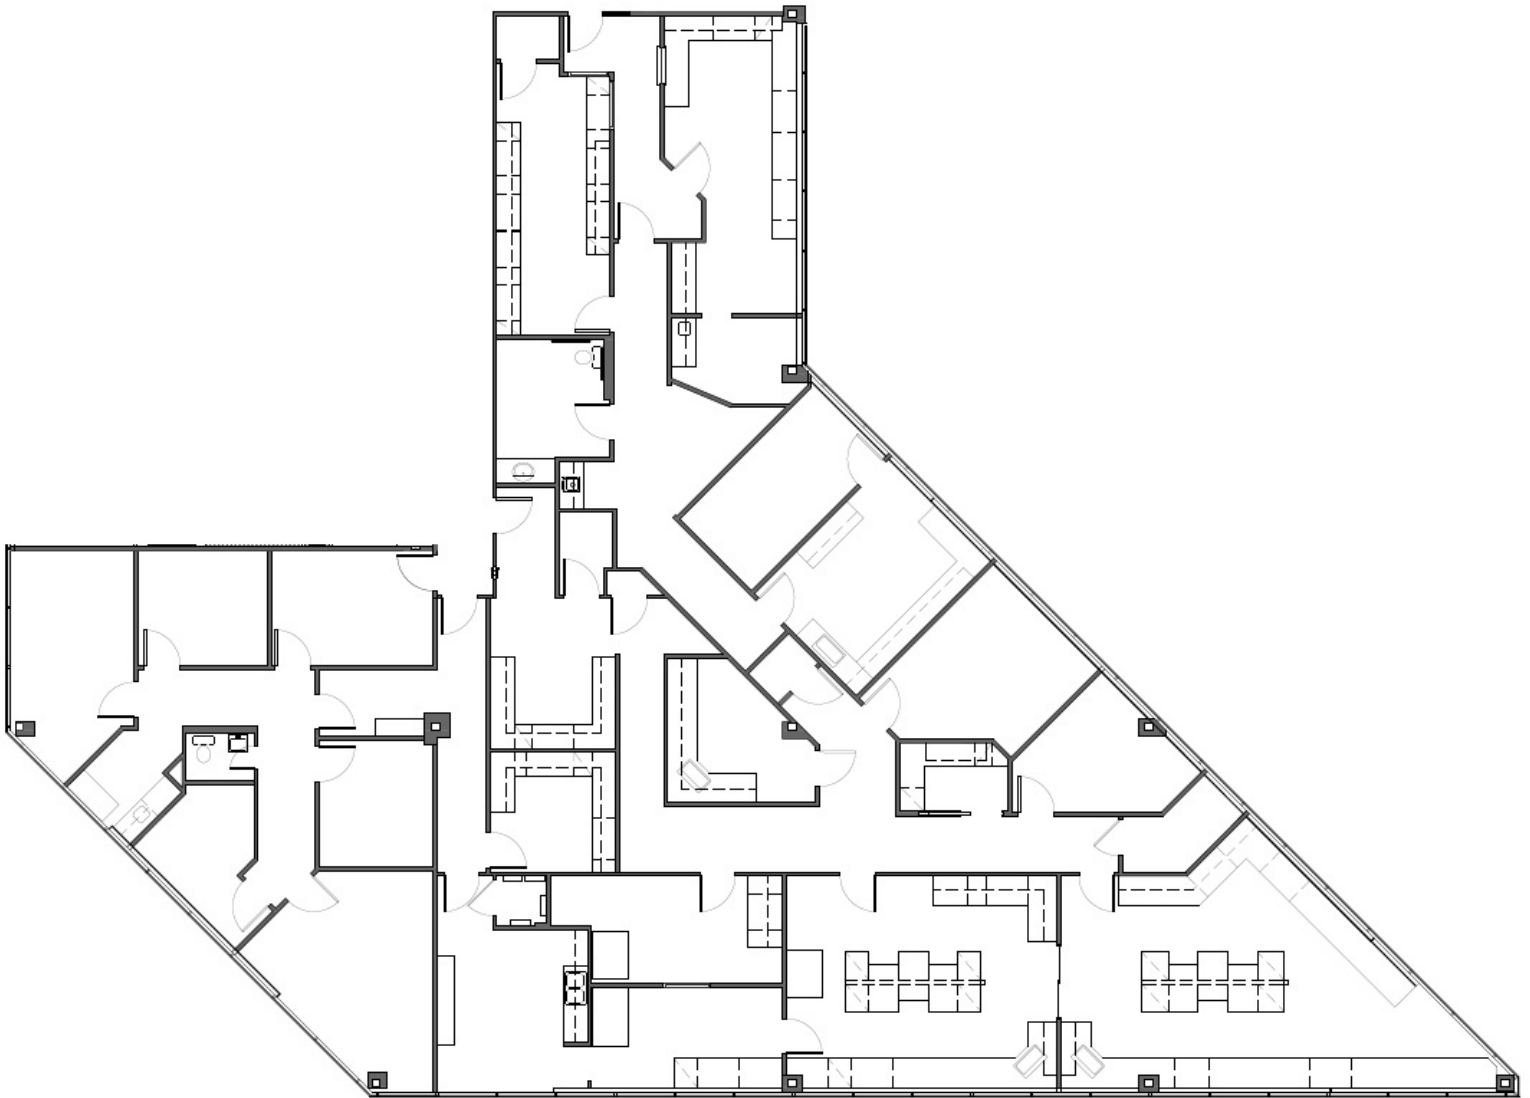

Leasing Information:

Sarah Carter | VP

713.231.1629

Sarah.Carter@transwestern.com

The information provided herein was obtained from sources believed reliable; however, Transwestern makes no guarantees, warranties or representations as to the completeness of accuracy thereof. The presentation of this property is submitted subject to errors, omissions, change of price or conditions, prior to sale or lease, or withdrawal without notice. Copyright © 2023 Transwestern.